

LABOR AND MATERIALS

1	Copper	} Connection	_____	\$ _____	
Lead					
1	Curb	} Cock Valve } T.S. & V. }	_____ in.	\$ _____	
	Service box		} Short 3 1/2 x 4 1/2 } Long 4 1/2 x 5 1/2 }	_____	\$ _____
	Old returned				_____
38	Ft. 3/4 in.	} Copper } G.I. } G.I. }	Pipe at _____	\$ _____	
	Nipples	_____ in. at _____	\$ _____		
	Bushings	_____ to _____ in. at _____	\$ _____		
	Red'g } Inc'g }	} Coupl'gs _____ to _____ in. at _____	\$ _____		
	Union		_____ in. at _____	\$ _____	
	Meter	_____ in. at _____	\$ _____		
	Compound Joints	at _____	\$ _____		
	Maintenance Foreman	_____	\$ _____		
	Hrs. Water Maint. Man-1	at _____	\$ _____		
	Hrs. Water Maint. Man-2	at _____	\$ _____		
	Hrs. Garage Foreman	_____ at _____	\$ _____		
	Hrs. Labor	_____ at _____	\$ _____		
	Hrs. Compressor	at _____	\$ _____		
	Trucking	_____	\$ _____		
	Pav't Patch	_____	\$ _____		
			\$ _____		
			\$ _____		
			\$ _____		
			\$ _____		


BROAD

St. ~~Pl.~~ Ave. No. 146

Name of Owner _____

Labor and Mat'l. Report

JUNE 19 33

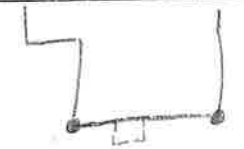

55'10" 49'3"

● Curb Box

6" Main

Elev. of Main at tap 5'

Gate at ●

● Gate at

● Curb Box