


LABOR AND MATERIALS

Copper	} Connection	3/4"	_____	\$ _____
Lead				
Curb	} Cock Valve T.S. & V.	3/4" in.	_____	\$ _____
Service box	} Short 3 1/2 x 4 1/2	_____	_____	\$ _____
Old returned				
88 Ft. 3/4" in.	} Copper	_____	Pipe at _____	\$ _____
Nipples	in. at _____	_____	\$ _____	
Bushings	to _____ in. at _____	_____	\$ _____	
Red'g	} Coupl'gs	to _____ in. at _____	\$ _____	
Inc'g				
Union	in. at _____	\$ _____		
Meter	in. at _____	\$ _____		
Compound Joints	at _____	\$ _____		
Maintenance Foreman	_____	\$ _____		
Hrs. Water Maint. Man-1	at _____	\$ _____		
Hrs. Water Maint. Man-2	at _____	\$ _____		
Hrs. Garage Foreman	at _____	\$ _____		
Hrs. Labor	at _____	\$ _____		
Hrs. Compressor	at _____	\$ _____		
Trucking	_____	\$ _____		
Pav't Patch	_____	\$ _____		
	_____	\$ _____		
	_____	\$ _____		
BROAD St. Pl. No. 150-54
 Ave. No. 150-54
 Name of Owner
 GAS STATION

Labor and Mat'l. Report 1962

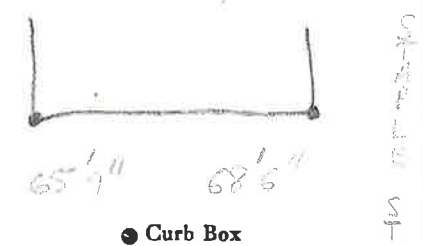

TAP ON BROAD ST
 6" Main Elev. of Main at tap 5'
 Gate at • Gate at •

• Curb Box
 THIS STOP IS ON WITH
 IN OFF POSITION