

LABOR AND MATERIALS

1	Copper Lead	Connection	2 <sup>11</sup>	\$
1	Curb	Cock Valve T.S. & V.	3/4" in.	\$
1	Service box Old returned	Short 3 1/2 x 4 1/2 Long 4 1/2 x 5 1/2		\$
9	Ft.	3/4" in. Copper G.I. Pipe		\$
	Nipples	in. at		\$
	Bushings	to in. at		\$
	Red'g Inc'g	Coupl'gs to in. at		\$
	Union	in. at		\$
	Meter	in. at		\$
	Compound Joints	at		\$
	Maintenance Foreman			\$
	Hrs. Water Maint. Man-1	at		\$
	Hrs. Water Maint. Man-2	at		\$
	Hrs. Garage Foreman	at		\$
	Hrs. Labor	at		\$
	Hrs. Compressor	at		\$
	Trucking			\$
	Pav't Patch			\$
				\$
				\$
BROAD

St. Pl. No. 153  
Ave. No.

Name of Owner

Labor and Mat'l. Report

JULY 1927

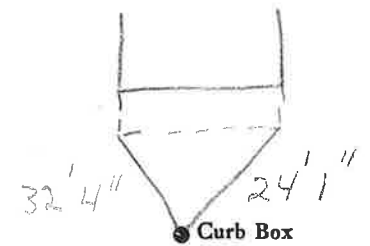

6" Main

Elev. of Main at tap 4 1/2'

Gate at ●

● Gate at

● Curb Box