


LABOR AND MATERIALS

_____	Copper } Connection _____	\$ _____
_____	Lead } _____	\$ _____
_____	Curb } Cock _____	\$ _____
_____	} Valve _____	\$ _____
_____	} T.S. & V. _____	\$ _____
_____	Service box { Short 3-1/2 x 4-1/2 } _____	\$ _____
_____	Old returned { Long 4-1/2 x 5-1/2 } _____	\$ _____
_____	Ft. _____ in. { Copper } Pipe at _____	\$ _____
_____	} G.I. _____	\$ _____
_____	} C.I. _____	\$ _____
_____	Nipples _____ in. at _____	\$ _____
_____	Bushings _____ to _____ in. at _____	\$ _____
_____	Red'g _____	\$ _____
_____	Inc'g _____	\$ _____
_____	Union _____ in. at _____	\$ _____
_____	Meter _____ in. at _____	\$ _____
_____	_____	\$ _____
_____	Compound Joints at _____	\$ _____
_____	Maintenance Foreman _____	\$ _____
_____	Hrs. Water Maint. Man - 1 at _____	\$ _____
_____	Hrs. Water Maint. Man - 2 at _____	\$ _____
_____	Hrs. Garage Foreman _____ at _____	\$ _____
_____	Hrs. Labor _____ at _____	\$ _____
_____	Hrs. Compressor at _____	\$ _____
_____	_____	\$ _____
_____	Trucking _____	\$ _____
_____	Pav't Patch _____	\$ _____
_____	_____	\$ _____
_____	_____	\$ _____
Broad st. St. Ave. No. 155

Name of Owner _____

Labor and Mat'l. Report 19 _____

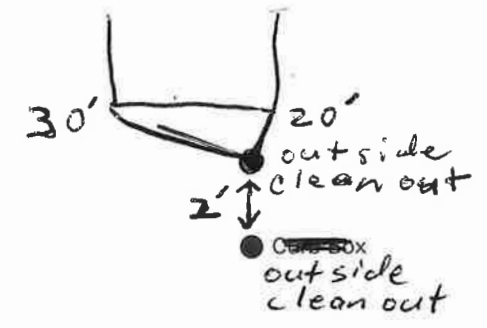

_____ Main Elev. of Main at tap _____

Gate at ● Gate at ●

TAX ID # 309.7-12-29

● Curb Box

LABOR AND MATERIALS

Copper	}	Connection		\$	
Lead					
Curb	}	Cock	} in.	\$	
		Valve			
		T. S. & V.			
Service box	}	Short 3½ x 4½	} \$		
Old returned		Long 4½ x 5½			
		Buff or Rdway			
Ft.	}	Copper	} Pipe at	\$	
in.		G. I.			
		C. I.			
Nipples	in.	at		\$	
Bushings	to	in.	at	\$	
Red'g	}	Coupl'gs	to	in.	at
Inc'g					
Union	in.	at		\$	
Meter	in.	at		\$	
Lead Joints	at			\$	
Compound Joints	at			\$	
Maintenance Foreman				\$	
Hrs. Water Maint. Man-1	at			\$	
Hrs. Water Maint. Man-2	at			\$	
Hrs. Garage Foreman	at			\$	
Hrs. Labor	at			\$	
Hrs. Compressor	at			\$	
Compensation Ins.	at \$	per C		\$	
Trucking				\$	
Pav't Patch				\$	
				\$	
				\$	
O'head				\$	
				\$	


BROAD

St.
Pl. Ave. No. 155

Name of Owner

Labor and Mat'l. Report

19

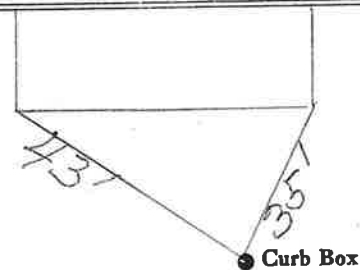

Main

Elev. of
Main at tap

Gate at •

• Gate at

• Curb Box

REMEASURED