


LABOR AND MATERIALS

1	Copper Lead	Connection	3/4	\$
1	Curb	Cock Valve T.S. & V.	3/4 in.	\$
	Service box	Short 3 1/2 x 4 1/2		
	Old returned	Long 4 1/2 x 5 1/2		\$
38	Ft.	3/4 in. Copper G.I. G.I.	Pipe at	\$
	Nipples	in. at		\$
	Bushings	to in. at		\$
	Red'g Inc'g	Coupl'gs to in. at		\$
	Union	in. at		\$
	Meter	in. at		\$
	Compound Joints	at		\$
	Maintenance Foreman			\$
	Hrs. Water Maint. Man-1	at		\$
	Hrs. Water Maint. Man-2	at		\$
	Hrs. Garage Foreman	at		\$
	Hrs. Labor	at		\$
	Hrs. Compressor	at		\$
	Trucking			\$
	Pav't Patch			\$
				\$
				\$
BROAD St. Ave. No. 160

Name of Owner

Labor and Mat'l. Report SEPT 1932

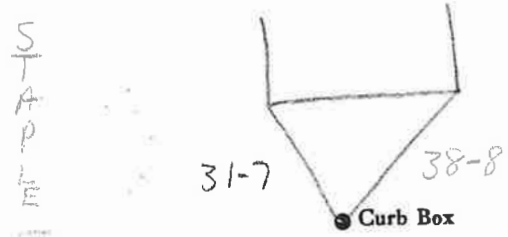

4" (P) Main BROAD ST Elev. of Main at tap 4 1/2

Gate at • • Gate at

TAX ID # 309.11-5-29

• Curb Box