

LABOR AND MATERIALS

1 Copper } Connection 3/4" \$  
 Lead }  
 1 Curb } Cock } 3/4 in. (MARK II) \$  
 Valve } (ORIS SEAL)  
 Service box } Short 3 1/2 x 4 1/2 }  
 Old returned } Long 4 1/2 x 5 1/2 } \$  
 Bur or Rdway }  
 39 Ft. 3/4 in. } Copper } Pipe at \$  
 } Galv. }  
 } Galv. }  
 Nipples \_\_\_\_\_ in. at \$  
 Bushings \_\_\_\_\_ to \_\_\_\_\_ in. at \$  
 Red'g }  
 Inc'g } Coupl'gs \_\_\_\_\_ to \_\_\_\_\_ in. at \$  
 Union \_\_\_\_\_ in. at \$  
 Meter \_\_\_\_\_ in. at \$  
 Lead Joints at \$  
 Compound Joints at \$  
 Maintenance Foreman \$  
 Hrs. Water Maint. Man—1 at \$  
 Hrs. Water Maint. Man—2 at \$  
 Hrs. Garage Foreman \_\_\_\_\_ at \$  
 Hrs. Labor— \_\_\_\_\_ at \$  
 Hrs. Compressor at \$  
 Compensation Ins. at \$ \_\_\_\_\_ per C \$  
 Trucking \$  
 Pav't Patch \$  
 TAP MADE BY  
 GIFFORD JCO  
 O'head NOV-1-1972 \$  
 \$

BROAD


St. No. 162

Name of Owner

Phil MACERO

Labor and Mat'l. Report

NOV 1 1972

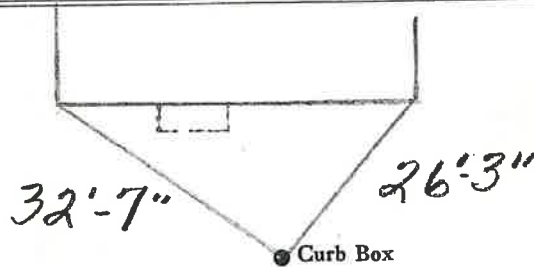

6" Main

Elev. of Main at tap 4'

Gate at ●

● Gate at

● Curb Box