

LABOR AND MATERIALS

	Copper	Connection	<u>3/4"</u>		\$
	Lead				
	Curb	Cock	<u>3/4"</u>	in.	\$
		Valve			
		T. S. & V.			
	Service box	Short $3\frac{1}{2} \times 4\frac{1}{2}$ Long $4\frac{1}{2} \times 5\frac{1}{2}$			
	Old returned				
<u>36</u>	Ft.	Copper G.I. G.I.	<u>3/4"</u>	in.	Pipe at \$
	Nipples	in.			\$
	Bushings			to in.	at \$
	Red'g	Coupl'gs			
	Inc'g		to in.		at \$
	Union	in.			at \$
	Meter	in.			at \$
					\$
	Compound Joints				at \$
	Maintenance Foreman				\$
	Hrs. Water Maint. Man—1				at \$
	Hrs. Water Maint. Man—2				at \$
	Hrs. Garage Foreman				at \$
	Hrs. Labor—				at \$
	Hrs. Compressor				at \$
					\$
	Trucking				\$
	Pav't Patch				\$
					\$
					\$

BROAD

St. ~~Pl.~~ 166
Ave. No.

Name of Owner _____

Labor and Mat'l. Report _____

1931

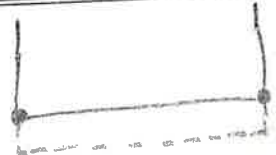

● Curb Box

4" Main

Elev. of Main at tap 4 1/2'

Gate at ●

● Gate at

● Curb Box