


Labor and Materials

Copper	}	Connection.....	\$. 1.50
Lead			
Curb	{	Cock Valve T.S. & V.	
	in.....	\$. 1.70
Service Box	{	Short 3 1/2 x 4 1/2	
Old returned		Long 4 1/2 x 6 1/2	
		Buff. or Rdwr.	\$. 1.44
3.8 Ft.	in.	{ Copper Cast Iron Cast Iron	Pipe at \$. 7.22
Nipplesin. at		\$.....
Bushingstoin. at		\$.....
Red'g Inc'g	{	Couplings.....to.....in. at	\$.....
Unionin. at		\$.....
Meterin. at		\$.....
Lbs. Br. Stone	at		\$.....
Lbs. Sand	at		\$.....
Bags Cement	at		\$.....
Paving Brick	{	Mack Red Asphalt	at \$.....
Lead Joints	at		\$.....
Leadite Joints	at		\$.....
5 Hrs.	Foreman	at 6.21 v \$. 3.12
11.2 Hrs.	Common Labor	at 25% of 3.2 \$. 0.26
17.2 Hrs.	Common Labor	at 45 \$. 1.94
Hrs.	Mason	at	\$.....
Hrs.	Masons Helper	at	\$.....
Hrs.	Compressor	at	\$.....
Compensation Ins			\$. 0.19
Trucking			\$. 1.50
Builders Use of Water			\$.....
Total			\$. 78 88

59 34 176
 Labor and Material Report July 26 1934

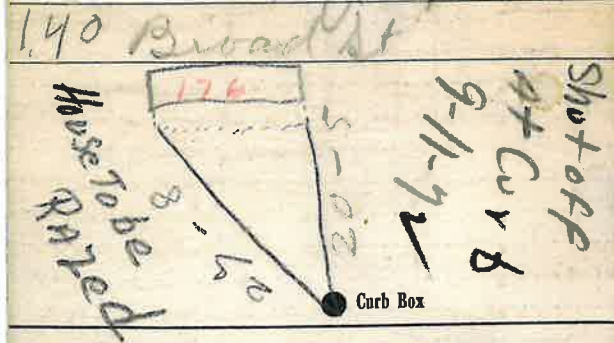

6 Main Elev. of Main at tap 5

Gate at ● ● Gate at

● Curb Box

Add 1/2 ft at main
 to be charge to
 Smokey.
 Suchman

JAS

1/2