


Labor and Materials

Copper } Connection.....	2	\$ 1.50
Lead }		
Curb { Cock Valve T.S.&V. }	2	\$ 1.70
Service Box { Short 3 1/2 x 4 1/2 }		\$ 1.44
Old returned { Long 4 1/2 x 5 1/2 }		
38 Ft. } in. { Copper Galv. Iron Cast Iron } Pipe at		\$ 7.27
Nipples		\$
Bushings		\$
Red'g } Couplings.....		\$
Inc'g }		\$
Union.....		\$
Meter.....		\$
Lbs. Br. Stone at		\$
Lbs. Sand at		\$
Bags Cement at		\$
Paving Brick { Mack Red Asphalt } at		\$
Lead Joints at		\$
Leadite Joints at		\$
5 Hrs. Foreman at	6.10	\$ 3.13
1.3 Hrs. Common Labor at	25% of 70	\$ 0.26
17.2 Hrs. Common Labor at	45	\$ 1.93
Hrs. Mason at		\$
Hrs. Masons Helper at		\$
Hrs. Compressor at		\$
Compensation Ins		\$ 0.19
Trucking		\$ 1.50
Builders Use of Water		\$
Total		\$ 18.87

Labor and Material Report
172 Burallo

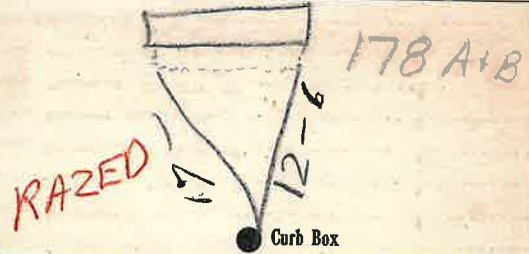

6 Main Elev. of Main at tap 5

Gate at ● Gate at ●

● Curb Box

old send off at main
to be charge.
Smokyushman

[Handwritten signature]

[Handwritten mark]