

LABOR AND MATERIALS

1	Copper Lead	Connection	3/4" Male Adapter 1 1/2" x 3/4" Tee	\$	53
1	Curb	Cock Valve T.S. & V.	in.	\$	3.41
1	Service box	Short 3 1/2 x 4 1/2			
	Old returned	Long 4 1/2 x 5 1/2			
		Buff or Rdway		\$	4.18
9	Ft. 3/4 in.	Copper G.I. C.I.	Pipe at	40	\$ 360
	Nipples	in. at		\$	
	Bushings	to in. at		\$	
	Red'g Inc'g	Coupl'gs to in. at		\$	
	Union	in. at		\$	
	Meter	in. at		\$	
	Lead Joints at			\$	5.28
	Compound Joints at			\$	
2	Maintenance Foreman	1.51	\$	3.02	
	Hrs. Water Maint. Man-1 at		\$		
	Hrs. Water Maint. Man-2 at		\$		
	Hrs. Garage Foreman at		\$		
2	Hrs. Labor	at 1.13	\$	2.26	
	Hrs. Compressor at		\$		
	Compensation Ins. at \$3.861 per C		\$	20	
	Trucking		\$	1.50	
	Pav't Patch		\$		
	Tap by Miller 10-4-54		\$		
	O'head		\$		
			\$	19.30	


42

84-54

Broad Acres Rd. St. Pl. Ave. No. 24

Name of Owner
Kenneth Collyer

Labor and Mat'l. Report Oct. 4 1954

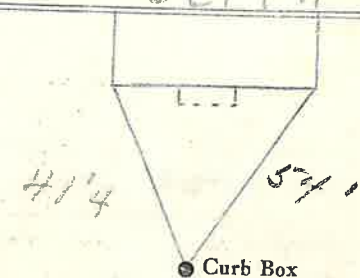

2" galv. Main Elev. of Main at tap 5'

Gate at • Gate at

• Curb Box