

LABOR AND MATERIALS


53

1	Copper Lead	Connection	3/4" Male Adapter		
1	Curb	Cock Valve T.S. & V.	2" x 3/4" Tee	\$ 2.41	
1	Service box Old returned		3/4 in.	\$ 3.41	
			Short 3 1/2 x 4 1/2		
			Long 4 1/2 x 5 1/2		
			Buff or Rdway	\$ 4.18	
32	Ft.	3/4 in.	Copper G.I. Pipe at	40	\$ 12.80
	Nipples	in. at		\$	
	Bushings	to in. at		\$	
	Red'g Inc'g	Coupl'gs to in. at		\$	
	Union	in. at		\$	
	Meter	in. at		\$	
	Lead Joints at			\$	
	Compound Joints at			\$	
	Maintenance Foreman			\$	
9	Hrs. Water Maint. Man-1 at			\$	
	Hrs. Water Maint. Man-2 at			\$	
	Hrs. Garage Foreman at			\$	
8	Hrs. Labor at			\$	
	Hrs. Compressor at			\$	
	Compensation Ins. at	\$ 3.861 per C.		\$	
	Trucking			\$ 1.50	
	Pay't Patch			\$	
	Tap by Miller	10-4-54		\$	
	O'head			\$	

Broad Acres Rd. St. Pl. Ave. No. 33 ✓

Name of Owner
Dr. Colson

Labor and Mat'l. Report Oct. 4 19 54

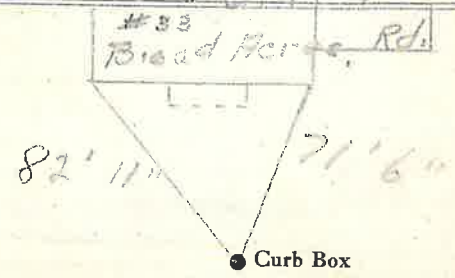

2" galv. Main Elev. of Main at tap 3'

Gate at • Gate at •

This Tap measured from 33 Broad Acres Rd.