

LABOR AND MATERIALS


53

1	Copper Lead	Connection	3/4" Male Adapter in 2" x 3/4"	\$
1	Curb	Cock Valve T.S. & V.	3/4" Tee	\$ 3.41
1	Service box	Short 3 1/2 x 4 1/2		
	Old returned	Long 4 1/2 x 5 1/2		
		Buff or Rdway		\$ 4.18
8	Ft. 3/4 in.	Copper G.I. C.I.	Pipe at 40	\$ 3.20
	Nipples	in. at		\$
	Bushings	to in. at		\$
	Red'g Inc'g	Coupl'gs to in. at		\$
	Union	in. at		\$
	Meter	in. at		\$
	Lead Joints	at		\$
	Compound Joints	at		\$
	Maintenance Foreman			\$
	Hrs. Water Maint. Man-1	at		\$
	Hrs. Water Maint. Man-2	at		\$
	Hrs. Garage Foreman	at		\$
	Hrs. Labor	at		\$
	Hrs. Compressor	at		\$
	Compensation Ins.	at \$ 3.861 per C		\$
	Trucking			\$
	Pay't Patch			\$
	Tap by Miller	10-4-54		\$
	O'head			\$

St. Pl. Ave. No. Broad Acres Rd.

Name of Owner HUTCHINSON

Labor and Mat'l. Report Oct 4 1954

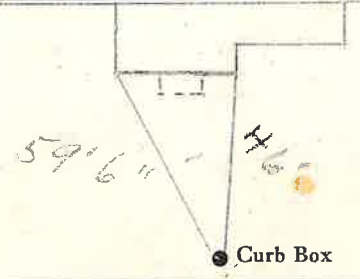

2" galv. Main Elev. of Main at tap 3'

Gate at • Gate at •

• Curb Box