

Labor and Materials

1	Copper Lead	Connection	3/4		\$ 1.43
1	Curb	Cock Valve	3/4 in		\$ 1.88
		T.S. & V.			
1	Service Box Old returned	Short	3 1/2 x 4 1/2	} Pipe at 21.35	\$ 40.57
		Long	4 1/2 x 5 1/2		
		Buff. or Rdway			
192	Ft.	3/4 in.			
	Nipples	in. at			
	Bushings	to in. at			
	Red's Inc's	Conplings	to in. at		
	Union	in. at			
	Meter	in. at			
	Lead Joints	at			
	Leadite Joints	at			
	Hrs. Foreman	at			
7	Hrs. Chauffeur	at	6 1/2		\$ 1.38
20	Hrs. Tapper	at	"		\$ 12.50
74	Hrs. Labor	at	45		\$ 32.50
	Hrs. Labor	at			
	Hrs. Compressor	at			
	Compensation Ins.				
	Trucking				\$ 1.38
	Builders Use of Water				\$ 9.-
3	ctoc 3/4" pipes		co 56		\$ 16.5
	subvn. & other				\$ 10.-
	Tap made by Messell				\$
					\$ 112.17


Refund of \$ 81.20 mailed to John W. Kelly
1.17.19-19.11.1919

5 8-1937

St. Pt. Ave. No. Lot 5
Broadacre St. Road

Name of Owner
John Kelly (Outside City)

Labor and Mat'l. Report June 23 & 24 1937

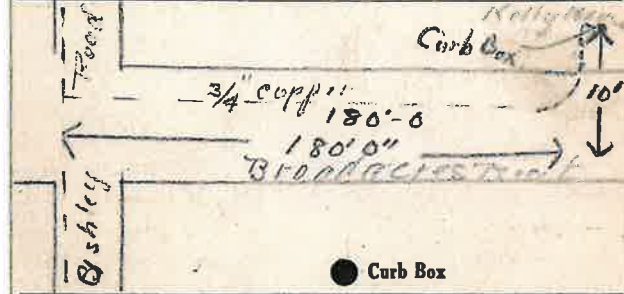

12" Main Elev. of Main at tap 5'

Gate at ● Gate at ●

● Curb Box

New House

