


BUSH

St. Ave. No. 53-55

Name of Owner

TAX ID# - 309.15-8-5

Labor and Mat'l. Report 19

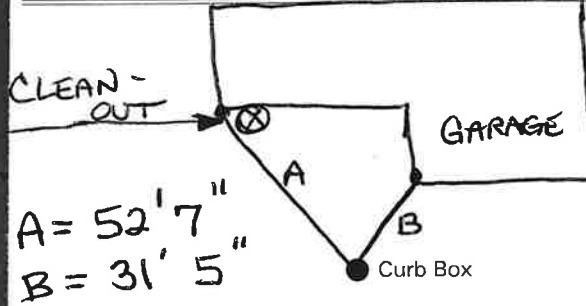

_____ Main

Elev. of Main at tap _____

Gate at ●

● Gate at

● Curb Box