

LABOR AND MATERIALS


? Copper } Connection _____ \$ _____	
Lead } _____ \$ _____	
1 Curb } Cock Valve } _____ in. \$ _____	
	T. S. & V. }
Service box } Short 3½ x 4½ } _____ \$ _____	
Old returned } Long 4½ x 5½ } _____ \$ _____	
	Buff or Rdway }
? Ft. _____ in. } Copper } Pipe at _____ \$ _____	
	G. I. ? }
	C. I. ? }
Nipples _____ in. at _____ \$ _____	
Bushings _____ to _____ in. at _____ \$ _____	
Red'g } _____ \$ _____	
Inc'g } Coupl'gs _____ to _____ in. at _____ \$ _____	
Union _____ in. at _____ \$ _____	
Meter _____ in. at _____ \$ _____	
Lead Joints at _____ \$ _____	
Compound Joints at _____ \$ _____	
Maintenance Foreman _____ \$ _____	
Hrs. Water Maint. Man—1 at _____ \$ _____	
Hrs. Water Maint. Man—2 at _____ \$ _____	
Hrs. Garage Foreman _____ at _____ \$ _____	
Hrs. Labor— _____ at _____ \$ _____	
Hrs. Compressor at _____ \$ _____	
Compensation Ins. at \$ _____ per C _____ \$ _____	
Trucking _____ \$ _____	
Pav't Patch _____ \$ _____	
_____ \$ _____	
_____ \$ _____	
_____ \$ _____	
O'head _____ \$ _____	
_____ \$ _____	

Bush St. Pl. Ave. No. *60*

Name of Owner *Merritt.*

Measured in *Nov. 15-67.*

Labor and Mat'l. Report 19

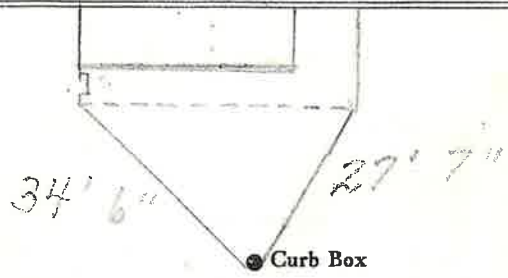

6" Main Elev. of Main at tap *4-5'*

Gate at • • • • • Gate at

● Curb Box

Disconnected at main 1-22-68. By Gifford, L. ...

LSM-5C-6-1-67 *House Razed, Curb box still in ground.*