

LABOR AND MATERIALS

1	Copper } Connection	3/4"	\$ 2.76
	Lead }		
1	Curb } Cock	3/4" in.	\$ 3.49
	Valve }		
	F. S. & V. }		
1	Service box	Short 3 1/2 X 4 1/2	\$ 4.74
17	Old returned	Long 4 1/2 X 5 1/2	
		Buffer Rdway	
10	Ft. 3/4 in.	Copper } Pipe at 35	\$ 3.50
		C.I. }	
		C.I. }	
	Nipples	in. at	\$
	Bushings	to in. at	\$
	Red'g		\$
	Inc'g	Coupl'gs to in. at	\$
	Union	in. at	\$
	Meter	in. at	\$
	Lead Joints	at	\$
	Compound Joints	at	\$
4	Hrs. Water Maint. Man-1	at 1.34	\$ 5.36
4	Hrs. Water Maint. Man-2	at 1.24	\$ 4.96
12	Hrs. Labor	at 1.13	\$ 13.56
	Hrs. Labor	at	\$
1	Hrs. Compressor	at	\$ 1.50
	Compensation Ins. at \$	per C	\$ .88
	Trucking		\$ 1.00
	Pay't Patch		\$
Tap by Gifford 5-21-52			
			\$
			\$
	O'head		\$
			\$ 41.75

Tap #38 - 1952

St.

Pl.

Ave. No. 31-33


Bush

Name of Owner

Dawn H. Mingo

Labor and Mat'l. Report

May 21 1952

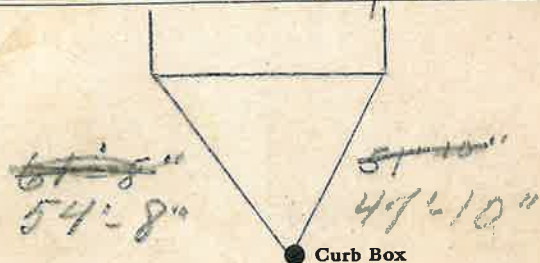

6" Main

Elev. of Main at tap 4 1/2'

Gate at ●

● Gate at

17' to MAIN

● Curb Box