

LABOR AND MATERIALS


1 Copper } Connection ^{3/4} \$ _____
 Lead }
 1 Curb } Cock Valve } 1" in. \$ _____
 T.S. & V. }
 Service box } Short 3 1/2 x 4 1/2 }
 Old returned } Long 4 1/2 x 5 1/2 }
 BUFFALO \$ _____
 23 Ft. 1" in. } Copper } Pipe at \$ _____
 } G. I. }
 } G.P. }
 Nipples in. at \$ _____
 Bushings to in. at \$ _____
 Red'g }
 Inc'g } Coupl'gs. to in. at \$ _____
 Union in. at \$ _____
 Meter in. at \$ _____
 \$ _____
 Compound Joints at \$ _____
 Maintenance Foreman \$ _____
 Hrs. Water Maint. Man—1 at \$ _____
 Hrs. Water Maint. Man—2 at \$ _____
 Hrs. Garage Foreman at \$ _____
 Hrs. Labor at \$ _____
 Hrs. Compressor at \$ _____
 \$ _____
 Trucking \$ _____
 Pav't Patch \$ _____
 \$ _____
 \$ _____
~~St.~~
~~Pl.~~
 BYRNE Ave. No. 22

Name of Owner

Labor and Mat'l. Report

19 24

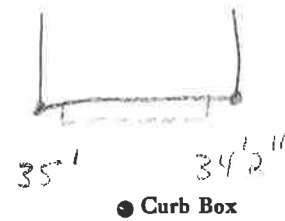

12" Main Elev. of Main at tap 3'

Gate at ●

● Gate at

● Curb Box