


LABOR AND MATERIALS

1	Copper	} Connection	3/4"	\$	
	Lead				
1	Curb	} Cock	3/4 in. Oriseal	\$	
					} Valve
1	Service box	} Short 3 1/2 x 4 1/2		\$	
	Old returned				} Long 4 1/2 x 5 1/2
12 Ft.	3/4 in.	} Copper	} Pipe at	\$	
					} G.I.
	Nipples	in. at	\$		
	Bushings	to in. at	\$		
	Red'g	} Coupl'gs	to in. at	\$	
	Inc'g				
	Union	in. at	\$		
	Meter	in. at	\$		
	Lead Joints	at	\$		
	Compound Joints	at	\$		
	Maintenance Foreman		\$		
	Hrs. Water Maint. Man	1 at	\$		
	Hrs. Water Maint. Man	2 at	\$		
	Hrs. Garage Foreman	at	\$		
	Hrs. Labor	at	\$		
	Hrs. Compressor	at	\$		
	Compensation Ins.	at \$ per C	\$		
	Trucking		\$		
	Pav't Patch		\$		
	Tap by Kelly & Co.		\$		
	10-9-64.		\$		
	O'head		\$		
			\$		

Byrne -St. Ave. No. 35

Name of Owner Poranski.

Labor and Mat'l. Report Oct. 9 1964.

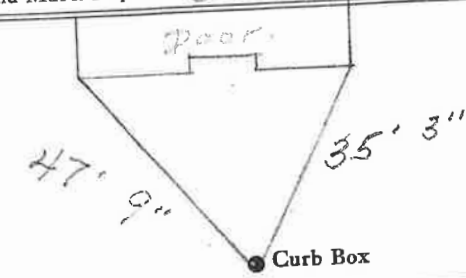

12" Main Elev. of Main at tap 7'

Gate at • Gate at •

TAX ID # 303.9-16-9

• Curb Box