

LABOR AND MATERIALS

1 Copper { Connection $\frac{3}{4}$ } \$ 1.31
 Lead }
 1 Curb { Cock Valve } \$ 1.75
 { T. S. & V. } $\frac{3}{4}$ in.
 1 Service Box { Short $3\frac{1}{2} \times 4\frac{1}{2}$ } \$ 1.60
 Old returned { Long $4\frac{1}{2} \times 5\frac{1}{2}$ }
 { Buff. or Rdway }
 25 Ft. $\frac{3}{4}$ in. { Copper Galv. Iron } Pipe at 18 \$ 4.50
 { Cast Iron }
 Nipples in. at \$
 Bushings to in. at \$
 Red'g } Couplings to in. at \$
 Inc'g }
 Union in. at \$
 Meter in. at \$
 Lead Joints at \$
 Leadite Joints at \$
 Hrs. Foreman at \$
 4 Hrs. Chauffeur at $6\frac{1}{2}$ \$ 2.50
 11 Hrs. Tapper at 7 \$ 6.88
 12 Hrs. Labor at 45 \$ 5.40
 Hrs. Labor at \$
 Hrs. Compressor at \$
 Compensation Ins. \$.45
 Trucking \$ 1.-
 Builders Use of Water Patch \$ 5.-
 Taggby Hessel \$
 \$ 30.39

1940

St.

Pl.

Byrne


Ave. No. 8

Name of Owner

Drake

Labor and Mat'l. Report

May 1940

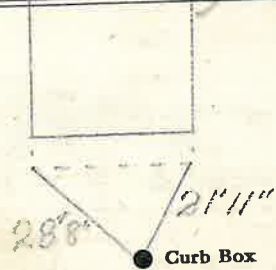

12" Main

Elev. of Main at tap. 5

Gate at

Gate at

Curb Box

old shut off