

LABOR AND MATERIALS

1 Copper } Connection ^{3/4"} \$ _____
 1 Lead }
 1 Curb } Cock } 3/4 in. DRISRAI \$ _____
 } Valve }
 } ~~Flange V.~~ }
 1 Service box } { Short 3 1/2 x 4 1/2 }
 Old returned } { Long 4 1/2 x 5 1/2 }
 } { Bull or Rdway } \$ _____
 17 Ft. 3/4 in. } { Copper } Pipe at \$ _____
 } { Gal }
 } { C.I. }
 _____ Nipples _____ in. at \$ _____
 _____ Bushings _____ to _____ in. at \$ _____
 _____ Red'g }
 _____ Inc'g } Coupl'gs _____ to _____ in. at \$ _____
 _____ Union _____ in. at \$ _____
 _____ Meter _____ in. at \$ _____
 _____ Lead Joints at \$ _____
 _____ Compound Joints at \$ _____
 _____ Maintenance Foreman \$ _____
 _____ Hrs. Water Maint. Man-1 at \$ _____
 _____ Hrs. Water Maint. Man-2 at \$ _____
 _____ Hrs. Garage Foreman _____ at \$ _____
 _____ Hrs. Labor _____ at \$ _____
 _____ Hrs. Compressor at \$ _____
 _____ Compensation Ins. at \$ _____ per C \$ _____
 _____ Trucking \$ _____
 _____ Pav't Patch \$ _____
TAP BY PUYVIS & CO \$ _____
OCT-28-1975 \$ _____
 _____ O'head \$ _____
 _____ \$ _____

BYRNE


St
Bl
Ave. No. 39

Name of Owner

Paul Girard

Labor and Mat'l. Report

Oct 28 1975

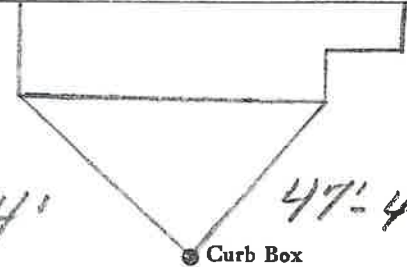

● Curb Box

12" Main

Elev. of Main at tap 6'

Gate at ●

● Gate at

● Curb Box