


LABOR AND MATERIALS

1	Copper Lead	Connection	3/4"	\$
1	Curb	Cock Valve T.S. & V.	3/4 in.	\$
1	Service box Old returned	Short 3 1/2 x 4 1/2 Long 4 1/2 x 5 1/2 Buff or Rdway		\$
10	Ft.	3/4 in. Copper G.I. G.I.	Pipe at	\$
	Nipples	in.	at	\$
	Bushings	to	in. at	\$
	Red'g Inc'g	Coupl'gs	to in. at	\$
	Union	in.	at	\$
	Meter	in.	at	\$
	Lead Joints	at		\$
	Compound Joints	at		\$
	Maintenance Foreman			\$
	Hrs. Water Maint. Man	1 at		\$
	Hrs. Water Maint. Man	2 at		\$
	Hrs. Garage Foreman	at		\$
	Hrs. Labor	at		\$
	Hrs. Compressor	at		\$
	Compensation Ins.	at \$	per C	\$
	Trucking			\$
	Pav't Patch			\$
	Tap by Gifford & Co.			\$
	11-21-60.			\$
	O'head			\$

St. Pl. Ave. No. 16  
Cameron

Name of Owner  
Miellette

Labor and Mat'l. Report Nov. 21 1960

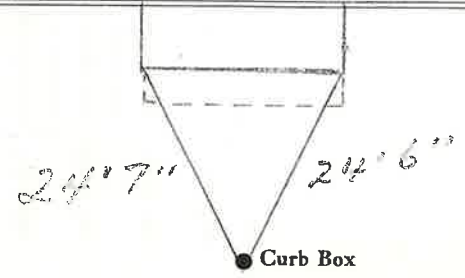

4" C.I. Main Elev. of Main at tap 4"

Gate at • Gate at •

TAX ID # 302.12-25-9

• Curb Box