

LABOR AND MATERIALS


1	Copper	} Connection	3/4"	\$	
	Lead				
1	Curb	} Cock	3/4" in.	\$	
		Valve			
		T.S. & V.			
1	Service box	{	Short 3 1/2 x 4 1/2	\$	
	Old returned		Long 4 1/2 x 5 1/2		
			Buff or Rdway		
11	Ft.	{	Copper	\$	
	3/4" in.		C.I.		
			C.I.		
	Nipples	in. at		\$	
	Bushings	to in. at		\$	
	Red'g	} Coupl'gs	to in. at	\$	
	Inc'g				
	Union	in. at		\$	
	Meter	in. at		\$	
	Lead Joints	at		\$	
	Compound Joints	at		\$	
	Maintenance Foreman			\$	
	Hrs. Water Maint. Man-1	at		\$	
	Hrs. Water Maint. Man-2	at		\$	
	Hrs. Garage Foreman	at		\$	
	Hrs. Labor	at		\$	
	Hrs. Compressor	at		\$	
	Compensation Ins. at \$	per C		\$	
	Trucking			\$	
	Pav't Patch			\$	
	lap May 16, 1977				\$
	O'head			\$	

CAMERON

St.
Pl. 18
Ave. No.

Name of Owner
Alexander Beszczyński

Labor and Mat'l. Report May 16 1977

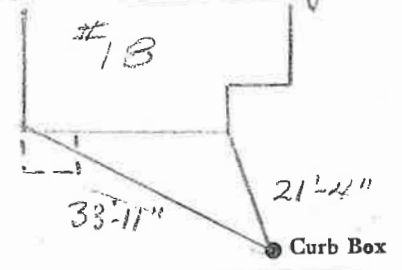

6 Main Elev. of
Main at tap

Gate at ● ● Gate at

TAX ID # 302.12-25-10

● Curb Box