

LABOR AND MATERIALS


1	Copper Lead	} Connection $\frac{3}{4}$ "	\$
1	Curb		} Cook Valve T.S. & V. $\frac{3}{4}$ " in.
1	Service box Old returned	} Short $3\frac{1}{2}$ x $4\frac{1}{2}$ Long $4\frac{1}{2}$ x $5\frac{1}{2}$	
19	Ft. $\frac{3}{4}$ "		} { Copper C.I. C.I. } Pipe at
	Nipples	in. at	
	Bushings	to in. at	\$
	Red'g Inc'g	} Coupl'gs to in. at	\$
	Union		in. at
	Meter	in. at	\$
	Compound Joints	at	\$
	Maintenance Foreman		\$
	Hrs. Water Maint. Man-1	at	\$
	Hrs. Water Maint. Man-2	at	\$
	Hrs. Garage Foreman	at	\$
	Hrs. Labor	at	\$
	Hrs. Compressor	at	\$
	Trucking		\$
	Pav't Patch		\$
			\$
			\$
CAMERON

St. _____
Pl. _____
Ave. No. 13

Name of Owner
TAX ID # 302.12-13-63

Labor and Mat'l. Report 1927

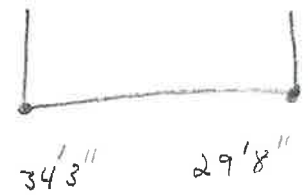

● Curb Box

4" Main Elev. of Main at tap 4'

Gate at ● Gate at

● Curb Box