


LABOR AND MATERIALS

1 Copper } Connection $\frac{3}{4}$ " \$ _____
 Lead }
 1 Curb } Cock } $\frac{3}{4}$ in. \$ _____
 } Valve }
 } T.S. & V. }
 1 Service box { Short $3\frac{1}{2}$ x $4\frac{1}{2}$ }
 Old returned { Long $4\frac{1}{2}$ x $5\frac{1}{2}$ }
 } Buff or Rdway } \$ _____
 2.5 Ft. $\frac{3}{4}$ in. { Copper } Pipe at \$ _____
 } G.I. }
 } C.I. }
 Nipples in. at \$ _____
 Bushings to in. at \$ _____
 Red'g }
 Inc'g } Coupl'gs to in. at \$ _____
 Union in. at \$ _____
 Meter in. at \$ _____
 Lead Joints at \$ _____
 Compound Joints at \$ _____
 Maintenance Foreman \$ _____
 Hrs. Water Maint. Man-1 at \$ _____
 Hrs. Water Maint. Man-2 at \$ _____
 Hrs. Garage Foreman at \$ _____
 Hrs. Labor at \$ _____
 Hrs. Compressor at \$ _____
 Compensation Ins. at \$ _____ per C \$ _____
 Trucking \$ _____
 Pav't Patch \$ _____
 Tap by Gifford & Co. \$ _____
 16-11/13-56. \$ _____
 O'head \$ _____
 \$ _____

Carleton Ct.
 St. Ave. No. 1

Name of Owner

Labor and Mat'l. Report June 11/13 1956

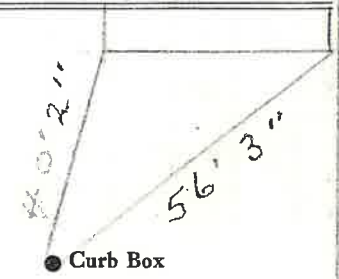

Carleton Ct.
 6" Main Elev. of Main at tap 5-8"

Gate at • Gate at

• Curb Box

Measured from
 South Side of
 #1 Carleton Ct.

LA ROSE ST.