


LABOR AND MATERIALS

_____ Copper } Connection _____ \$ _____	
_____ Lead } _____	
_____ Curb } Cock _____	
_____ Valve } _____ in. _____ \$ _____	
_____ T.S. & V. } _____	
_____ Service box { Short 3-1/2 x 4-1/2 } _____ \$ _____	
_____ Old returned { Long 4-1/2 x 5-1/2 } _____	
_____ Ft. _____ in. { Copper } Pipe at _____ \$ _____	
_____ G.I. }	
_____ C.I. }	
_____ Nipples _____ in. at _____ \$ _____	
_____ Bushings _____ to _____ in. at _____ \$ _____	
_____ Red'g _____	
_____ Inc'g _____	
_____ Union _____ in. at _____ \$ _____	
_____ Meter _____ in. at _____ \$ _____	
_____ _____ \$ _____	
_____ Compound Joints at _____ \$ _____	
_____ Maintenance Foreman _____ \$ _____	
_____ Hrs. Water Maint. Man - 1 at _____ \$ _____	
_____ Hrs. Water Maint. Man - 2 at _____ \$ _____	
_____ Hrs. Garage Foreman _____ at _____ \$ _____	
_____ Hrs. Labor _____ at _____ \$ _____	
_____ Hrs. Compressor at _____ \$ _____	
_____ _____ \$ _____	
_____ Trucking _____ \$ _____	
_____ Pav't Patch _____ \$ _____	
_____ _____ \$ _____	
_____ _____ \$ _____	
St. _____
 Pl. _____
 Ave. No. 11

Name of Owner
Carleton CT

Labor and Mat'l. Report 19

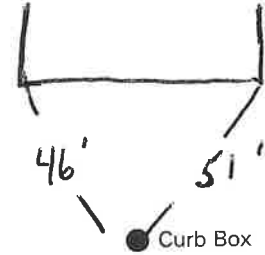

_____ Main Elev. of Main at tap _____

Gate at ● Gate at ●

● Curb Box

LABOR AND MATERIALS

1	Copper	} Connection	3/4"		\$
	Lead				
1	Curb	} Cock Valve	3/4 in.		\$
		T. S. & V.			
1	Service box	}	Short 3 1/2 x 4 1/2		
	Old returned		Long 4 1/2 x 5 1/2		
			Buff or Rdway		
25	Ft. 3/4 in.	Copper	}	Pipe at	\$
		G.I.			
		C.I.			
	Nipples	in. at			\$
	Bushings	to in. at			\$
	Red'g	} Coupl'gs	to in. at		\$
	Inc'g				
	Union	in. at			\$
	Meter	in. at			\$
	Lead Joints at				\$
	Compound Joints at				\$
	Maintenance Foreman				\$
	Hrs. Water Maint. Man	1 at			\$
	Hrs. Water Maint. Man	2 at			\$
	Hrs. Garage Foreman	at			\$
	Hrs. Labor	at			\$
	Hrs. Compressor at				\$
	Compensation Ins. at \$	per C			\$
	Trucking				\$
	Pav't Patch				\$
	Tap by Gifford & Co				\$
					\$
					\$
	O'head				\$

Tap by Gifford & Co

6-11-13-56

Ct.
St.
Pt.
Ave. No. 11

Carleton

Name of Owner

Labor and Mat'l. Report June 11-13 1956

Lot Tap

● Curb Box

6" Main

Elev. of Main at tap 5' 10 8

Gate at ●

● Gate at

Carleton Ct.

