

LABOR AND MATERIALS


1 Copper } Connection  $\frac{3}{4}$ " \$ \_\_\_\_\_  
 Lead }  
 1 Curb } Cock }  $\frac{3}{4}$  in. \$ \_\_\_\_\_  
 Valve }  
 T.S. & V. }  
 1 Service box } Short  $3\frac{1}{2}$  x  $4\frac{1}{2}$  }  
 Old returned } Long  $4\frac{1}{2}$  x  $5\frac{1}{2}$  } \$ \_\_\_\_\_  
 Buff. or Rdway }  
 15 Ft.  $\frac{3}{4}$  in. } Copper } Pipe at \$ \_\_\_\_\_  
 } G.I. }  
 } G.I. }  
 Nipples \_\_\_\_\_ in. at \$ \_\_\_\_\_  
 Bushings \_\_\_\_\_ to \_\_\_\_\_ in. at \$ \_\_\_\_\_  
 Red'g }  
 Inc'g } Coupl'gs. \_\_\_\_\_ to \_\_\_\_\_ in. at \$ \_\_\_\_\_  
 Union \_\_\_\_\_ in. at \$ \_\_\_\_\_  
 Meter \_\_\_\_\_ in. at \$ \_\_\_\_\_  
 Lead Joints at \$ \_\_\_\_\_  
 Compound Joints at \$ \_\_\_\_\_  
 Maintenance Foreman \$ \_\_\_\_\_  
 Hrs. Water Maint. Man—1 at \$ \_\_\_\_\_  
 Hrs. Water Maint. Man—2 at \$ \_\_\_\_\_  
 Hrs. Garage Foreman \_\_\_\_\_ at \$ \_\_\_\_\_  
 Hrs. Labor— \_\_\_\_\_ at \$ \_\_\_\_\_  
 Hrs. Compressor at \$ \_\_\_\_\_  
 Compensation Ins. at \$ \_\_\_\_\_ per C \$ \_\_\_\_\_  
 Trucking \$ \_\_\_\_\_  
 Pav't Patch \$ \_\_\_\_\_  
 Tap by Gifford & Co. \$ \_\_\_\_\_  
 June 11-13-56 \$ \_\_\_\_\_  
 O'head \$ \_\_\_\_\_  
 \$ \_\_\_\_\_

Lot # 14

Carleton Ct. St. No. 14  
 Pl. Ave. No.

Name of Owner  
 Beatrice Gornbein

Labor and Mat'l. Report June 11-13 1956

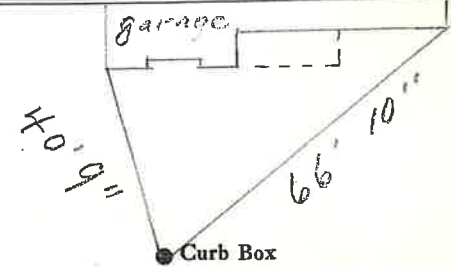

6" Main Elev. of Main at tap 5-8'

Gate at • Gate at

• Curb Box