


LABOR AND MATERIALS

1	Copper Lead	Connection	3/4"	\$
1	Curb	Cock Valve T. S. & V.	3/4 in.	\$
1	Service box Old returned	{ Short 3 1/2 x 4 1/2 Long 4 1/2 x 5 1/2 Buff or Rdway		\$
25	Ft.	{ Copper C. I. C. I.	3/4 in. Pipe at	\$
_____	Nipples	in. at		\$
_____	Bushings	to in. at		\$
_____	Red'g } Inc'g }	Coupl'gs	to in. at	\$
_____	Union	in. at		\$
_____	Meter	in. at		\$
_____	Lead Joints	at		\$
_____	Compound Joints	at		\$
_____	Maintenance Foreman			\$
_____	Hrs. Water Maint. Man-1	at		\$
_____	Hrs. Water Maint. Man-2	at		\$
_____	Hrs. Garage Foreman	at		\$
_____	Hrs. Labor	at		\$
_____	Hrs. Compressor	at		\$
_____	Compensation Ins.	at \$ per C		\$
_____	Trucking			\$
_____	Pay't Patch			\$
_____	Tap by G. Stord & Co.			\$
_____	In 1956			\$
_____	O'head			\$

St. Carleton Ct.
Pl. 9
Ave. No. 9

Name of Owner
W. Romano

Labor and Mat'l. Report June 1956

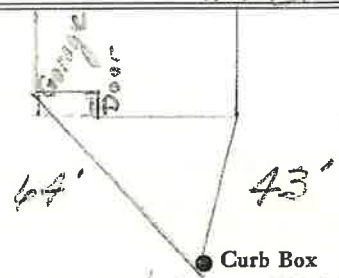

Measured in 1965

6" C.I. Main Elev. of Main at tap 570.8'

Gate at ● Gate at ●

● Curb Box