

LABOR AND MATERIALS

1	Copper Lead	Connection	$\frac{3}{4}$	\$	1.35
1	Curb	Cock Valve T. S. & V.	$\frac{3}{4}$ in.	\$	1.88
1	Service Box Old returned	Short $3\frac{1}{2} \times 4\frac{1}{2}$ Long $4\frac{1}{2} \times 5\frac{1}{2}$ Buff. or Rdway		\$	1.82
12	Ft.	$\frac{3}{4}$ in.	Copper Galv-Iron Cast-Iron Pipe at 20	\$	2.40
	Nipples	in. at		\$	
	Bushings	to in. at		\$	
	Red'g Inc'g	Couplings to in. at		\$	
	Union	in. at		\$	
	Meter	in. at		\$	
	Lead Joints	at		\$	
	Leadite Joints	at		\$	
	Hrs. Foreman	at		\$	
	Hrs. Chauffeur	at		\$	
	Hrs. Tapper	at		\$	
	Hrs. Labor	at		\$	
	Hrs. Labor	at		\$	
	Hrs. Compressor	at		\$	
	Compensation Ins.			\$	
	Trucking			\$	
	Builders Use of Water			\$	
	Tap by <i>Waisniski</i>			\$	
				\$	
				\$	
				\$	
				\$	

St.

47 1942

St. *11*

Pl- *#7*
Ave. No.


Center

Name of Owner

Knight

Labor and Mat'l. Report

Aug 21 19*42*

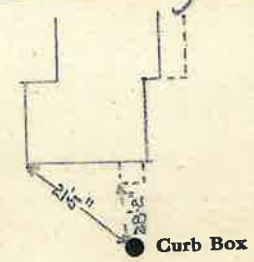

● Curb Box

4 Main

Elev. of Main at tap *5-*

Gate at ●

● Gate at

● Curb Box

(To be Billed)