

LABOR AND MATERIALS

1	Copper } Connection	$\frac{3}{4}$ "	\$
	Lead }		
1	Curb } Cock	$\frac{3}{4}$ "	\$
	} Valve		
	} T.S. & V.		
1	Service box	Short $3\frac{1}{2} \times 4\frac{1}{2}$	\$
	Old returned	Long $4\frac{1}{2} \times 5\frac{1}{2}$	\$
8	Ft. $\frac{3}{4}$ " in.	{ Copper } Pipe at	\$
		{ Galv. }	
		{ Galv. }	
	Nipples	in. at	\$
	Bushings	to in. at	\$
	Red'g }		
	Inc'g }	Coupl'gs to in. at	\$
	Union	in. at	\$
	Meter	in. at	\$
			\$
	Compound Joints	at	\$
	Maintenance Foreman		\$
	Hrs. Water Maint. Man	—1 at	\$
	Hrs. Water Maint. Man	—2 at	\$
	Hrs. Garage Foreman	at	\$
	Hrs. Labor	at	\$
	Hrs. Compressor	at	\$
			\$
	Trucking		\$
	Pav't Patch		\$
			\$
			\$
CENTER

St.
 Pl.
 Ave. No. 13

Name of Owner

Labor and Mat'l. Report

MAY 1928

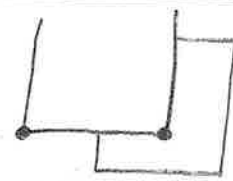

26' 23'7"

● Curb Box

4" Main

Elev. of Main at tap 5'

Gate at ●

● Gate at

● Curb Box