


LABOR AND MATERIALS

1	Copper <del>Lead</del>	Connection	3/4"	\$	_____
1	Curb	Cock Valve T.S. & V.	3/4" in.	\$	_____
1	Service box Old returned	{ Short 3 1/2 x 4 1/2 Long 4 1/2 x 5 1/2 }		\$	_____
20	Ft.	3/4" in. { Copper <del>C.I.</del> <del>C.I.</del> }	Pipe at	\$	_____
	Nipples	in. at		\$	_____
	Bushings	to in. at		\$	_____
	Red'g Inc'g	Coupl'gs to in. at		\$	_____
	Union	in. at		\$	_____
	Meter	in. at		\$	_____
	Compound Joints	at		\$	_____
	Maintenance Foreman			\$	_____
	Hrs. Water Maint. Man-1	at		\$	_____
	Hrs. Water Maint. Man-2	at		\$	_____
	Hrs. Garage Foreman	at		\$	_____
	Hrs. Labor	at		\$	_____
	Hrs. Compressor	at		\$	_____
	Trucking			\$	_____
	Pav't Patch			\$	_____
				\$	_____
				\$	_____
St. \_\_\_\_\_  
~~Pt.~~  
 Ave. No. 20  
 Name of Owner  
 TAX ID # 303.17-17-4

Labor and Mat'l. Report OCT 1925

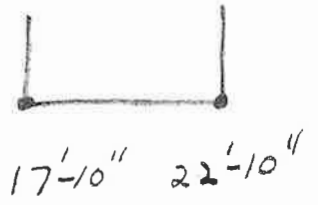

● Curb Box

4" Main Elev. of Main at tap 4 1/2'

Gate at ● Gate at

● Curb Box