


LABOR AND MATERIALS

Copper	} Connection	_____	\$ _____	
Lead				
Curb	} Cock Valve T.S. & V. }	_____ in.	\$ _____	
Service box		} Short 3 1/2 x 4 1/2 } Long 4 1/2 x 5 1/2 }	_____	\$ _____
Old returned				
176 ✓ Ft. 3/4 in.	} Copper } } G.I. } } G.I. }	Pipe at _____	\$ _____	
To Platt Main				
Nipples _____ in. at _____			\$ _____	
Bushings _____ to _____ in. at _____		\$ _____		
Red'g } Inc'g }	} Coupl'gs. _____ to _____ in. at _____		\$ _____	
Union _____ in. at _____			\$ _____	
Meter _____ in. at _____		\$ _____		
Compound Joints at _____		\$ _____		
Maintenance Foreman _____		\$ _____		
Hrs. Water Maint. Man-1 at _____		\$ _____		
Hrs. Water Maint. Man-2 at _____		\$ _____		
Hrs. Garage Foreman _____ at _____		\$ _____		
Hrs. Labor _____ at _____		\$ _____		
Hrs. Compressor at _____		\$ _____		
Trucking _____		\$ _____		
Pav't Patch _____		\$ _____		
_____		\$ _____		
_____		\$ _____		
_____		\$ _____		
_____		\$ _____		

St. _____
Pl. _____
Ave. No. 3

Charles
Name of Owner
Kevin Berkowitz

Labor and Mat'l. Report Aug. 19 89

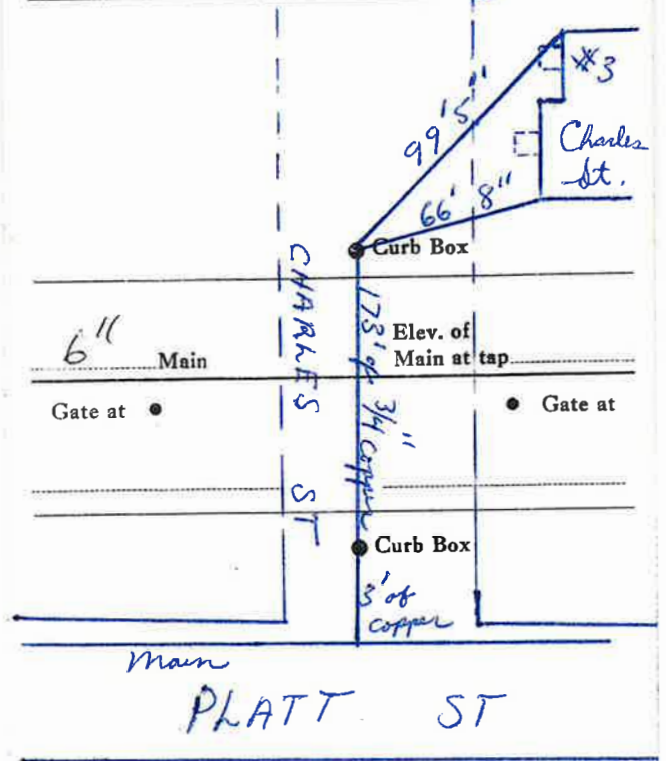

LSM-5C-6-1-67

TAX ID # 303.14-3-11