


LABOR AND MATERIALS

1	Copper	} Connection	3/4"	\$
	Lead			
1	Curb	} Cock Valve T.S. & V.	3/4" in.	\$
1	Service box			
	Old returned			
			Short 3 1/2 x 4 1/2	\$
			Long 4 1/2 x 5 1/2	
9	Ft. 3/4" in.	} Copper	Pipe at	\$
	Nipples	in. at	\$	
	Bushings	to in. at	\$	
	Red'g Inc'g	} Coupl'gs	to in. at	\$
	Union			
	Meter	in. at	\$	
	Compound Joints	at	\$	
	Maintenance Foreman		\$	
	Hrs. Water Maint. Man	1 at	\$	
	Hrs. Water Maint. Man	2 at	\$	
	Hrs. Garage Foreman	at	\$	
	Hrs. Labor	at	\$	
	Hrs. Compressor	at	\$	
	Trucking		\$	
	Pav't Patch		\$	
			\$	
			\$	
			\$	
			\$	

St. Pt. Ave. No. 17
 CHARLOTTE
 Name of Owner
 TAX ID # 302.20-4-11

Labor and Mat'l. Report
 OCT. 19 34

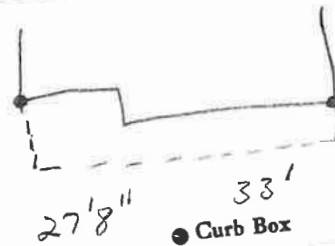

4" Main
 Gate at •
 Elev. of Main at tap 5 1/2'
 • Gate at

• Curb Box