


LABOR AND MATERIALS

1	Copper Lead	} Connection	3/4	_____	\$
1	Curb				
1	Service box Old returned	} Short 3 1/2 x 4 1/2 Long 4 1/2 x 5 1/2		_____	\$
13	Ft. 3/4 in.				
	Nipples	in. at	_____	\$	
	Bushings	to	in. at	_____	\$
	Red'g Inc'g	} Coupl'gs	to	in. at	\$
	Union				
	Meter	in. at	_____	\$	
	Compound Joints	at	_____	\$	
	Maintenance Foreman		_____	\$	
	Hrs. Water Maint. Man	1 at	_____	\$	
	Hrs. Water Maint. Man	2 at	_____	\$	
	Hrs. Garage Foreman	at	_____	\$	
	Hrs. Labor	at	_____	\$	
	Hrs. Compressor	at	_____	\$	
	Trucking		_____	\$	
	Pav't Patch		_____	\$	
			_____	\$	
			_____	\$	
St. CHARLOTTE
Ave. No. 6-8

Name of Owner _____
TAX ID # 302.20-3-2

Labor and Mat'l. Report SEPT. 19 38

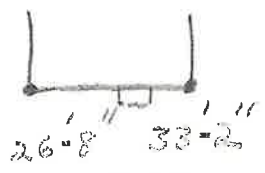

● Curb Box

4" Main Elev. of Main at tap 5'
Gate at ● Gate at ●

● Curb Box