

### LABOR AND MATERIALS


Copper	{ Connection	3/4	\$	2.29
Lead				
Curb	{ Cock Valve	3/4 in.	\$	2.70
	{ T.S. & V.			
Service box	{ Short 3 1/2 x 4 1/2		\$	4.25
Old returned	{ Long 4 1/2 x 5 1/2			
	{ Buff or Rdway		\$	4.20
12 Ft. 3/4 in.	{ Copper	Pipe at 35	\$	4.20
	{ G.I.			
	{ G.I.			
Nipples	in. at		\$	
Bushings	to in. at		\$	
Red'g	{ Coupl'gs	to in. at	\$	
Inc'g				
Union	in. at		\$	
Meter	in. at		\$	
Lead Joints at			\$	16.5
Compound Joints at			\$	
3 Hrs. Water Maint. Man-1 at	1.12	\$	3.36	
2 Hrs. Water Maint. Man-2 at	1.02	\$	2.04	
12 Hrs. Labor— at	91	\$	10.92	
Hrs. Labor— at		\$		
Hrs. Compressor at		\$		
Compensation Ins. at \$		per C.	\$	36
Trucking		\$	1.	
Pav't Patch	B.P.	\$		
O'head		\$		
		\$	31.12	

7-1950

Before Taving

St. Cataraugus  
 Ave. No. 7-9  
 Name of Owner John McQuira Boer

Labor and Mat'l. Report July 7 19 50

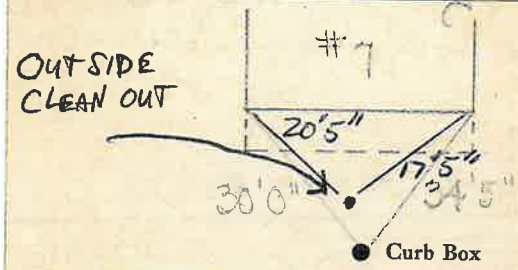

4" Main Elev. of Main at tap 5'  
 Gate at ● Gate at ●

● Curb Box  
 CURB BOX - "ON" POSITION  
 IS OFF