

### LABOR AND MATERIALS

1	Copper Lead	{ Connection	3/4	\$	2.29
1	Curb	{ Cock Valve F.S. & V. }	3/4 in.	\$	2.70
1	Service box Old-returned	{ Short 3 1/2 x 4 1/2 Long 4 1/2 x 5 1/2 Buff or Rdway }		\$	4.25
18	Ft. 3/4 in.	{ Copper G.I. C.I. }	Pipe at 35	\$	6.30
	Nipples	in. at		\$	
	Bushings	to in. at		\$	
	Red'g Inc'g	{ Coupl'gs to in. at }		\$	
	Union	in. at		\$	
	Meter	in. at		\$	
	Lead Joints	at		\$	
	Compound Joints	at		\$	
1 1/2	Hrs. Water Maint. Man-1	at	1 1/2	\$	1.68
3 1/2	Hrs. Water Maint. Man-2	at	1.02	\$	3.57
6 1/2	Hrs. Labor	at	91	\$	5.92
	Hrs. Labor	at		\$	
	Hrs. Compressor	at		\$	
	Compensation Ins. at \$	per C.		\$	1.25
	Trucking			\$	
	Pav't Patch			\$	
	O'head			\$	
				\$	27.96


110-1950

Before Paving

Charlotte St. Pl. No. 12

Name of Owner  
Louis Maron

Labor and Mat'l. Report July 7 19 50

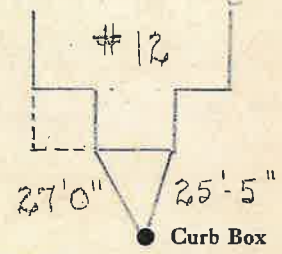

4" Main Elev. of Main at tap 5'  
Gate at ● Gate at ●

● Curb Box