

## LABOR AND MATERIALS

1	Copper	Connection	3/4		\$
	Lead				
1	Curb	Clock Valve	3/4	in.	\$
		T.S. & V.			
1	Service box	}	Short 3 1/2 X 4 1/2		\$
	Old returned		Long 4 1/2 X 5 1/2	Buff or Rdway	
5	Ft.	}	Copper	Pipe at	\$
	3/4		Galv. Iron		
			Cast Iron		
	Nipples			in. at	\$
	Bushings			to in. at	\$
	Red'g	}		to in. at	\$
	Inc'g				
	Union			in. at	\$
	Meter			in. at	\$
	Lead Joints				\$
	Compound Joints				\$
	Hrs. Foreman				\$
	Hrs. Chauffeur				\$
	Hrs. Tapper				\$
	Hrs. Labor				\$
	Hrs. Labor				\$
	Hrs. Compressor				\$
	Compensation Ins.				\$ 1.00
	Trucking				\$
	Builders Use of Water				\$

St.

PL

Ave. No. 3


*Cherry*

Name of Owner

TAX ID # 303.17-11-26

Labor and Mat'l. Report

*Curb 22* 19 *47*

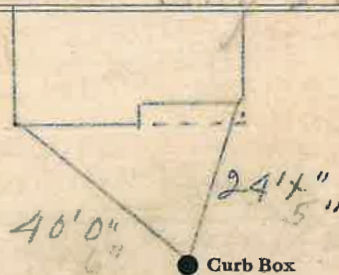

4 Main

Elev. of Main at tap 6

Gate at ●

● Gate at

● Curb Box