

LABOR AND MATERIALS

1	Copper Iron	Connection	3/4"	\$
1	Curb	Cock Valve T. S. & V.	3/4 in.	\$
1	Service box Old returned	Short 3 1/2 x 4 1/2 Long 4 1/2 x 5 1/2		\$
21	Ft.	3/4" in. { Copper G.I. G.I. }	Pipe at	\$
	Nipples	in. at		\$
	Bushings	to in. at		\$
1	Red'g Inc'g } Coupl'gs	3/4" to copper	in. at	\$
	Union	in. at		\$
	Meter	in. at		\$
	Compound Joints	at		\$
	Maintenance Foreman			\$
	Hrs. Water Maint. Man-1	at		\$
	Hrs. Water Maint. Man-2	at		\$
	Hrs. Garage Foreman	at		\$
	Hrs. Labor	at		\$
	Hrs. Compressor	at		\$
	Trucking			\$
	Pav't Patch			\$
				\$
				\$
CHERRY

St. ~~Pl.~~
Ave. No. 14

Name of Owner

Labor and Mat'l. Report

MAY 1925

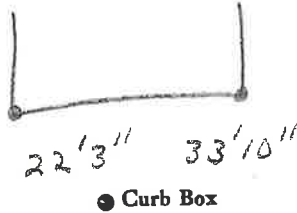

4" Main

Elev. of Main at tap 5'

Gate at ●

● Gate at

● Curb Box