

LABOR AND MATERIALS

1	Copper Lead	} Connection	3/4		\$ 2.80
1	Curb	{ Clock Valve F. S. & V. }	3/4	in.	\$ 3.60
1	Service box Old returned	{ Short 3" X 4" Long 4" X 5" Buff or Rdway }			\$ 5.80
7	Ft.	3/4 in. { Copper Galv. Iron Cast Iron }		} Pipe at	\$ 2.45
	Nipples	in. at			\$
	Bushings	to in. at			\$
	Red'g Inc'g	} Couplings		to in. at	\$
	Union		in. at		\$
	Meter	in. at			\$
	Lead Joints at				\$
	Compound Joints at				\$
	Hrs. Foreman at				\$
	Hrs. Chauffeur at				\$
	Hrs. Tapper at				\$
	Hrs. Labor at				\$
	Hrs. Labor at				\$
	Hrs. Compressor at				\$
	Compensation Ins.				\$
	Trucking				\$ 1.00
	Builders Use of Water				\$ 1.00
	<i>Tap by Miller</i>				
					\$
					\$
98-47

St.
Pl.
Ave. No. 15


Cherry

Name of Owner

Scarse Letta

Labor and Mat'l. Report

Aug 14 1947

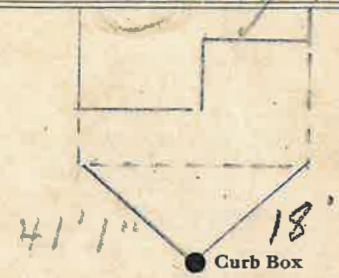

4

Main

Elev. of

Main at tap

6

Gate at ●

● Gate at

TAX ID # 303.17-11-20

● Curb Box