

LABOR AND MATERIALS

/	Copper Lead	} Connection	<u>3/4</u>		\$ 2.80
/	Curb	{ Clock Valve T. S. & V. }	<u>3/4</u>	in.	\$ 3.60
/	Service box Old returned	{ Short 3 1/2 X 4 1/2 Long 4 1/2 X 5 1/2 Buff or Rdway }			\$ 5.80
21	Ft.	<u>3/4</u> in.	{ Copper Galv. Iron Cast Iron }	Pipe at <u>35</u>	\$ 7.35
	Nipples in. at			\$
	Bushings to in. at			\$
	Red'g Inc'g	{ Couplings to in. at		\$
	Union in. at			\$
	Meter in. at			\$
	Lead Joints at				\$
	Compound Joints at				\$
	Hrs. Foreman at				\$
	Hrs. Chauffeur at				\$
	Hrs. Tapper at				\$
	Hrs. Labor at				\$
	Hrs. Labor at				\$
	Hrs. Compressor at				\$
	Compensation Ins.				\$
	Trucking				\$ <u>1.00</u>
	Builders Use of Water				\$
	<i>Tap & 1/2" pipe</i>				\$
					\$
					\$
					\$
					\$

92-47


V

Cherry

St. 78
Pl. 20
Ave. No. 20

Name of Owner
Fairchild

Labor and Mat'l. Report Aug 18 1947

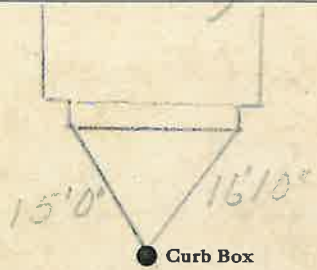

4 Main Elev. of Main at tap 5 1/2

Gate at ● ● Gate at

● Curb Box