

LABOR AND MATERIALS

1	Copper } Lead }	Connection $\frac{3}{4}$		\$
1	Curb	Cock Valve } T.S. & V. }	in.	\$
1	Service box Old returned	{ Short $3\frac{1}{2} \times 4\frac{1}{2}$ Long $4\frac{1}{2} \times 5\frac{1}{2}$ Buff or Rdway }		\$
10	Ft. $\frac{3}{4}$ in.	{ Copper G.I. C.I. }	Pipe at	\$
	Nipples	in. at		\$
	Bushings	to in. at		\$
	Red'g } Inc'g }	Coupl'gs to in. at		\$
	Union	in. at		\$
	Meter	in. at		\$
	Lead Joints	at		\$
	Compound Joints	at		\$
	Maintenance Foreman			\$
	Hrs. Water Maint. Man-1	at		\$
	Hrs. Water Maint. Man-2	at		\$
	Hrs. Garage Foreman	at		\$
	Hrs. Labor	at		\$
	Hrs. Compressor	at		\$
	Compensation Ins. at \$	per C		\$
	Trucking			\$
	Pav't Patch			\$
				\$
				\$
	O'head			\$
				\$


~~CHERRY~~

St. ~~Pl.~~
Ave. No. 15

Name of Owner _____

Labor and Mat'l. Report

1926

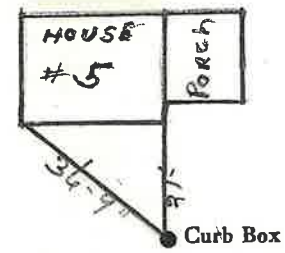

$\frac{4}{8}$ " Main

Elev. of Main at tap 6'

Gate at ●

● Gate at

● Curb Box