

LABOR AND MATERIALS

1	Copper	}	Connection	<u>3/4"</u>	\$	
	Lead					
1	Curb	}	Cock Valve	<u>3/4"</u>	\$	
			T.S. & V.			
1	Service box	}	Short	<u>3 1/2 x 4 1/2</u>	\$	
	Old returned		Long	<u>4 1/2 x 5 1/2</u>		
26	Ft.	}	Copper	Pipe at	\$	
	<u>3/4"</u>		Gal.			
	in.		Gal.			
	Nipples		in. at	\$		
	Bushings		to in. at	\$		
	Red'g	}	Coupl'gs	to in. at	\$	
	Ino'g					
	Union		in. at	\$		
	Meter		in. at	\$		
	Compound Joints		at	\$		
	Maintenance Foreman			\$		
	Hrs. Water Maint. Man		1 at	\$		
	Hrs. Water Maint. Man		2 at	\$		
	Hrs. Garage Foreman		at	\$		
	Hrs. Labor		at	\$		
	Hrs. Compressor		at	\$		
	Trucking			\$		
	Pav't Patch			\$		
				\$		
				\$		
				\$		
				\$		


CHERRY

St. _____
 Ave. No. 45AB

Name of Owner _____

Labor and Mat'l. Report _____

NOV 1929

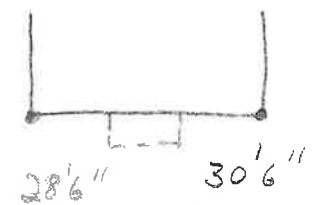

● Curb Box

12" Main

Elev. of Main at tap 4'

Gate at ●

● Gate at

● Curb Box