

LABOR AND MATERIALS


1	Copper Lead	} Connection <u>3/4</u>	\$
1	Curb		\$
		} Cock Valve T.S. & V. <u>3/4 in.</u>	\$
1	Service box Old returned		{ Short $3\frac{1}{2} \times 4\frac{1}{2}$ Long $4\frac{1}{2} \times 5\frac{1}{2}$
8	Ft. <u>3/4"</u>	} Copper C.I. C.I.	} Pipe at \$
	Nipples		
	Bushings	to in. at \$	
1	Red'g Incl'g	} Coupl'gs. <u>3/4"</u> to <u>3/4"</u> in. at \$	
	Union		in. at <u>NEAR MAIN No 3</u> \$
	Meter	in. at \$	
	Compound Joints	at \$	
	Maintenance Foreman	\$	
	Hrs. Water Maint. Man-1	at \$	
	Hrs. Water Maint. Man-2	at \$	
	Hrs. Garage Foreman	at \$	
	Hrs. Labor-	at \$	
	Hrs. Compressor	at \$	
	Trucking	\$	
	Pav't Patch	\$	
		\$	
		\$	
CHERRY

St. ~~Pl.~~
Ave. No. 46

Name of Owner
TAX ID # 303.17-1-4

Labor and Mat'l. Report APR 1932

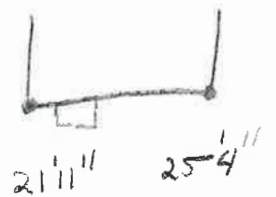

● Curb Box

12" Main

Elev. of
Main at tap 4 1/2'

Gate at ●

● Gate at

● Curb Box