

## LABOR AND MATERIALS


1	Copper Lead	Connection $\frac{3}{4}$		\$	
1	Curb	Cock Valve T. S. & V.	$\frac{3}{4}$ in.	\$	
1	Service box Old returned	Short $3\frac{1}{2} \times 4\frac{1}{2}$ Long <del>4<math>\frac{1}{2}</math> x 5<math>\frac{1}{2}</math></del>		\$	
7	Ft. $\frac{3}{4}$ in.	Copper G. I. Pipe		\$	
	Nipples	in. at		\$	
	Bushings	to in. at		\$	
	Red'g Inc'g	Coupl'gs to in. at		\$	
	Union	in. at		\$	
1	Meter $\frac{3}{4}$	in. at		\$	
	Compound Joints	at		\$	
	Maintenance Foreman			\$	
	Hrs. Water Maint. Man	1 at		\$	
	Hrs. Water Maint. Man	2 at		\$	
	Hrs. Garage Foreman	at		\$	
	Hrs. Labor	at		\$	
	Hrs. Compressor	at		\$	
	Trucking			\$	
	Pav't Patch			\$	
				\$	
				\$	
				\$	
				\$	

CHERRY

St. \_\_\_\_\_  
Pl. \_\_\_\_\_  
Ave. No. 52

Name of Owner \_\_\_\_\_

Labor and Mat'l. Report JUNE 1925

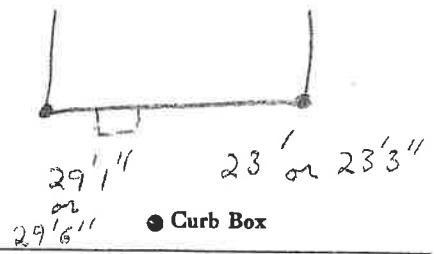

12'' Main

Elev. of Main at tap 4'

Gate at ● ● Gate at

● Curb Box