


LABOR AND MATERIALS

1	Copper Lead	} Connection $\frac{3}{4}$ "	\$	_____	
1	Curb Valve T.S. & V.		} $\frac{3}{4}$ " in.	\$	_____
1	Service box Old returned	} Short $3\frac{1}{2} \times 4\frac{1}{2}$ Long $4\frac{1}{2} \times 5\frac{1}{2}$		\$	_____
20	Ft. $\frac{3}{4}$ " in.		} Copper C.I. C.I.	} Pipe at	\$
	Nipples	in. at			\$
	Bushings	to in. at	\$	_____	
	Red'g Inc'g	} Coupl'gs	to in. at	\$	_____
	Union			in. at	\$
	Meter	in. at	\$	_____	
	Compound Joints	at	\$	_____	
	Maintenance Foreman		\$	_____	
	Hrs. Water Maint. Man-1	at	\$	_____	
	Hrs. Water Maint. Man-2	at	\$	_____	
	Hrs. Garage Foreman	at	\$	_____	
	Hrs. Labor	at	\$	_____	
	Hrs. Compressor		\$	_____	
	Trucking		\$	_____	
	Pav't Patch		\$	_____	
			\$	_____	
			\$	_____	
			\$	_____	
			\$	_____	

CHERRY St. No. 6
Pl. Ave. No. 6

Name of Owner _____

Labor and Mat'l. Report SEPT. 19 26

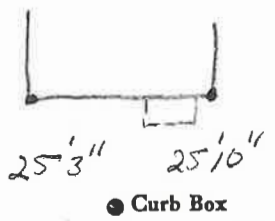

4" Main Elev. of Main at tap 6'

Gate at • Gate at

20' to MAIN

• Curb Box

TAX ID # 303.17-10-2