


LABOR AND MATERIALS

| | | | |
|--------------|---|--|----|
| BRASS | | | |
| 1 | Copper Lead | Connection $\frac{3}{4}$ | \$ |
| 1 | Curb | Cock Valve T.S. & V. } $\frac{3}{4}$ in. | \$ |
| 1 | Service box | Short $3\frac{1}{2} \times 4\frac{1}{2}$ | \$ |
| Old returned | Long $4\frac{1}{2} \times 5\frac{1}{2}$ | | |
| 24 | Ft. $\frac{3}{4}$ in. | Copper } Pipe at | \$ |
| | | C.I. | |
| | | C.I. | |
| | Nipples | in. at | \$ |
| | Bushings | to in. at | \$ |
| | Red'g | | |
| | Inc'g | Coupl'gs to in. at | \$ |
| | Union | in. at | \$ |
| | Meter | in. at | \$ |
| | | | \$ |
| | Compound Joints | at | \$ |
| | Maintenance Foreman | | \$ |
| | Hrs. Water Maint. Man-1 | at | \$ |
| | Hrs. Water Maint. Man-2 | at | \$ |
| | Hrs. Garage Foreman | at | \$ |
| | Hrs. Labor | at | \$ |
| | Hrs. Compressor | at | \$ |
| | | | \$ |
| | Trucking | | \$ |
| | Pav't Patch | | \$ |
| | | | \$ |
| | | | \$ |
St. CHERRY
 Pt. 55
 Ave. No. 55
 Name of Owner

Labor and Mat'l. Report SEPT 19 25

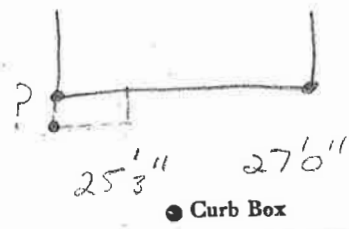

12" Main Elev. of Main at tap 5'
 Gate at • Gate at

TAX ID # 303.17-2-13

• Curb Box