

LABOR AND MATERIALS


3/4 Copper Connection _____ \$
 3/4 Curb } Cock } _____ in. \$
 } Valve }
 } T.S. & V. }
 _____ Service box { Short 3-1/2 x 4-1/2 } _____ \$
 _____ Old returned { Long 4-1/2 x 5-1/2 } _____ \$
 10 Ft. 3/4 in. { Copper } Pipe at _____ \$
 } G.I. }
 } C.I. }
 _____ Nipples _____ in. at _____ \$
 _____ Bushings _____ to _____ in. at _____ \$
 _____ Red'g _____
 _____ Inc'g _____
 _____ Union _____ in. at _____ \$
 _____ Meter _____ in. at _____ \$
 _____ _____ \$
 _____ Compound Joints at _____ \$
 _____ Maintenance Foreman _____ \$
 _____ Hrs. Water Maint. Man - 1 at _____ \$
 _____ Hrs. Water Maint. Man - 2 at _____ \$
 _____ Hrs. Garage Foreman _____ at _____ \$
 _____ Hrs. Labor _____ at _____ \$
 _____ Hrs. Compressor at _____ \$
 _____ _____ \$
 _____ Trucking _____ \$
 _____ Pav't Patch _____ \$
 _____ _____ \$
 _____ _____ \$
 _____ _____ \$
 _____ _____ \$

cherry

St. _____
 Pl. _____
 Ave. No. 66

Name of Owner _____

Labor and Mat'l. Report 19 10/24/00

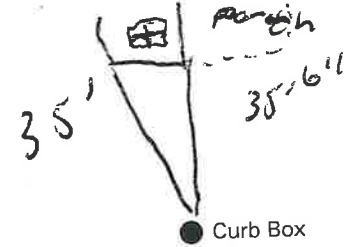

4" Main

Elev. of Main at tap 5'

Gate at ●

● Gate at

● Curb Box

Sewer 24' Feet From CURB BOX