

LABOR AND MATERIALS

/	Copper	} Connection	3/4		\$ 2.90
	Lead				
/	Curb	{ Clock Valve	{ 3/4	in.	\$ 3.60
		{ T. S. & V.			
/	Service box	{ Short 3 1/2 X 4 1/2			\$ 5.90
	Old returned	{ Long 4 1/2 X 5 1/2			
		{ Buffer Rdway			
24	Ft.	{ Copper		Pipe at	\$ 8.40
	3/4	{ Galv. Iron			
	in.	{ Cast Iron			
	Nipples	in.	at		\$
	Bushings	to	in.	at	\$
	Red'g	} Couplings	to	in.	at
	Inc'g				
	Union	in.	at		\$
	Meter	in.	at		\$
	Lead Joints	at			\$
	Compound Joints	at			\$
	Hrs. Foreman	at			\$
	Hrs. Chauffeur	at			\$
	Hrs. Tapper	at			\$
	Hrs. Labor	at			\$
	Hrs. Labor	at			\$
	Hrs. Compressor	at			\$
	Compensation Ins.				\$
	Trucking				\$ 1.00
	Builders Use of Water				\$
	Tap by Miller				\$
					\$
					\$
					\$
					\$

110-47


✓

St. _____
Pl. _____
Ave. No. 67

Cherry

Name of Owner
Connor

Labor and Mat'l. Report *Aug 21* 19 *47*

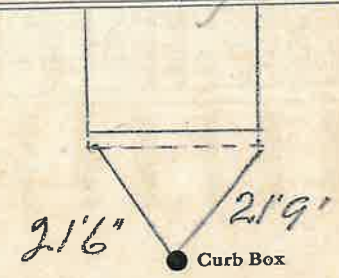

4 Main Elev. of Main at tap *5 1/2*

Gate at ● Gate at ●

● Curb Box

LABOR AND MATERIALS

Copper	}	Connection		\$	
Lead					
Curb	}	Cock	} in.	\$	
		Valve			
		T. S. & V.			
Service box	}	Short $3\frac{1}{2} \times 4\frac{1}{2}$	}	\$	
Old returned		Long $4\frac{1}{2} \times 5\frac{1}{2}$			
Ft. $\frac{3}{4}$ in.	}	Copper	} Pipe at	\$	
		C.T.			
		C.T.			
Nipples		in. at		\$	
Bushings		to in. at		\$	
Red'g	}	Coupl'gs	to in. at	\$	
Inc'g					
Union		in. at		\$	
Meter		in. at		\$	
				\$	
Compound Joints		at		\$	
Maintenance Foreman				\$	
Hrs. Water Maint. Man—1		at		\$	
Hrs. Water Maint. Man—2		at		\$	
Hrs. Garage Foreman		at		\$	
Hrs. Labor		at		\$	
Hrs. Compressor		at		\$	
				\$	
Trucking				\$	
Pav't Patch				\$	
				\$	
				\$	
				\$	
				\$	


CHERRY

St.
~~Pt.~~
Ave. No. 67

Name of Owner

Labor and Mat'l. Report

AUG. 1947

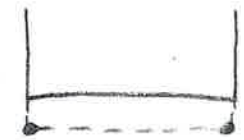

21'6" 21'9"

● Curb Box

4" Main

Elev. of
Main at tap 5 1/2'

Gate at ●

● Gate at

● Curb Box