

LABOR AND MATERIALS


| | | | | | |
|----|-----------------------------|---|-------------------|--|----|
| 1 | Copper Lead | Connection | $\frac{3}{4}$ | | \$ |
| 1 | Curb | Cock Valve T.S. & V. | $\frac{3}{4}$ in. | | \$ |
| 1 | Service box Old returned | Short $3\frac{1}{2} \times 4\frac{1}{2}$ Long $4\frac{1}{2} \times 5\frac{1}{2}$ | | | \$ |
| 10 | Ft. | $\frac{3}{4}$ in. Copper C.T. C.T. | Pipe at | | \$ |
| | Nipples | in. at | | | \$ |
| | Bushings | to in. at | | | \$ |
| | Red'g Inc'g | Coupl'gs | to in. at | | \$ |
| | Union | in. at | | | \$ |
| | Meter | in. at | | | \$ |
| | Compound Joints | at | | | \$ |
| | Maintenance Foreman | | | | \$ |
| | Hrs. Water Maint. Man | —1 at | | | \$ |
| | Hrs. Water Maint. Man | —2 at | | | \$ |
| | Hrs. Garage Foreman | at | | | \$ |
| | Hrs. Labor | at | | | \$ |
| | Hrs. Compressor | at | | | \$ |
| | Trucking | | | | \$ |
| | Pav't Patch | | | | \$ |
| | | | | | \$ |
| | | | | | \$ |
CHERRY

St. ~~Pl.~~
Ave. No. 74

Name of Owner

Labor and Mat'l. Report SEPT. 1929

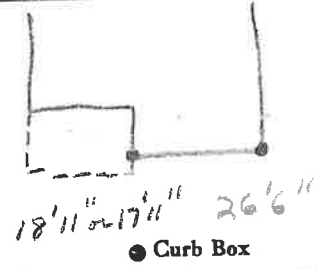

4" Main Elev. of Main at tap 5'

Gate at ● ● Gate at

● Curb Box