

LABOR AND MATERIALS

1	Copper	} Connection	3/4"	\$	
	Lead				
1	Curb	} Cock Valve Tr. S. & W.	3/4 in.	\$	
1	Service box	} Short 3 1/2 x 4 1/2		\$	
	Old returned				Long 4 1/2 x 5 1/2
23	Ft.	} Copper	3/4 in.	\$	
					C.I.
	Nipples	in.	at	\$	
	Bushings	to	in.	at	
	Red'g	} Coupl'gs	to	in.	at
	Inc'g				
	Union	in.	at	\$	
	Meter	in.	at	\$	
				\$	
	Compound Joints	at		\$	
	Maintenance Foreman			\$	
	Hrs. Water Maint. Man—1	at		\$	
	Hrs. Water Maint. Man—2	at		\$	
	Hrs. Garage Foreman	at		\$	
	Hrs. Labor—	at		\$	
	Hrs. Compressor	at		\$	
				\$	
	Trucking			\$	
	Pav't Patch			\$	
				\$	
				\$	
				\$	
				\$	


St. ~~Pl.~~  
Ave. No. 27

CHESTER

Name of Owner \_\_\_\_\_

TAX ID # 302.16-18-2

Labor and Mat'l. Report OCT. 1928

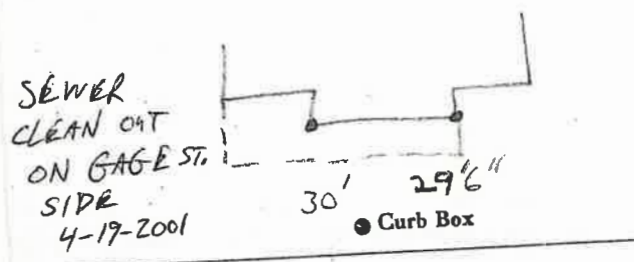

10" Main

Elev. of Main at tap 4 1/2'

Gate at ●

● Gate at

● Curb Box