


Labor and Materials

| | | | |
|----|------------------------|--|----|
| 1 | Copper | Connection | \$ |
| | Lead | | \$ |
| | Curb | { Cock Valve } T. S. & V. } in. | \$ |
| | Service Box | { Short 3 1/2 x 4 1/2 } Old returned { Long 4 1/2 x 5 1/2 } Buff. or Rdway } | \$ |
| 18 | Ft. 3/4 in. | { Copper } { Galv. Iron } { Cast Iron } Pipe at | \$ |
| | Nipples | in. at | \$ |
| | Bushings | to in. at | \$ |
| | Red'g Inc'g | Couplings to in. at | \$ |
| | Union | in. at | \$ |
| | Meter | in. at | \$ |
| | Lbs. Br. Stone | at | \$ |
| | Lbs. Sand | at | \$ |
| | Bags Cement | at | \$ |
| | Paving Brick | { Mack } { Red } { Asphalt } at | \$ |
| | Lead Joints | at | \$ |
| | Leadite Joints | at | \$ |
| | Hrs. Foreman | at | \$ |
| | Hrs. Common Labor | at | \$ |
| | Hrs. Common Labor | at | \$ |
| | Hrs. Mason | at | \$ |
| | Hrs. Mason's Helper | at | \$ |
| | Hrs. Compressor | at | \$ |
| | Compensation Ins. | | \$ |
| | Trucking | | \$ |
| | Builders' Use of Water | | \$ |
| | Total | \$ | \$ |

Labor and Material Report

Oct 31 1918

29 Chester St (Braudet)

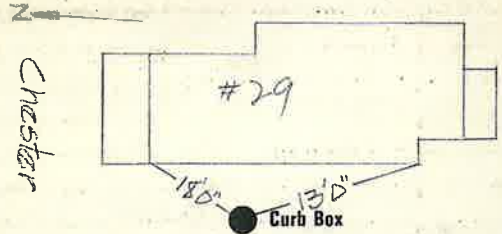

4 Main *Gage Ave* Elev. of Main at tap

Gate at ● Gate at ●

● Curb Box